
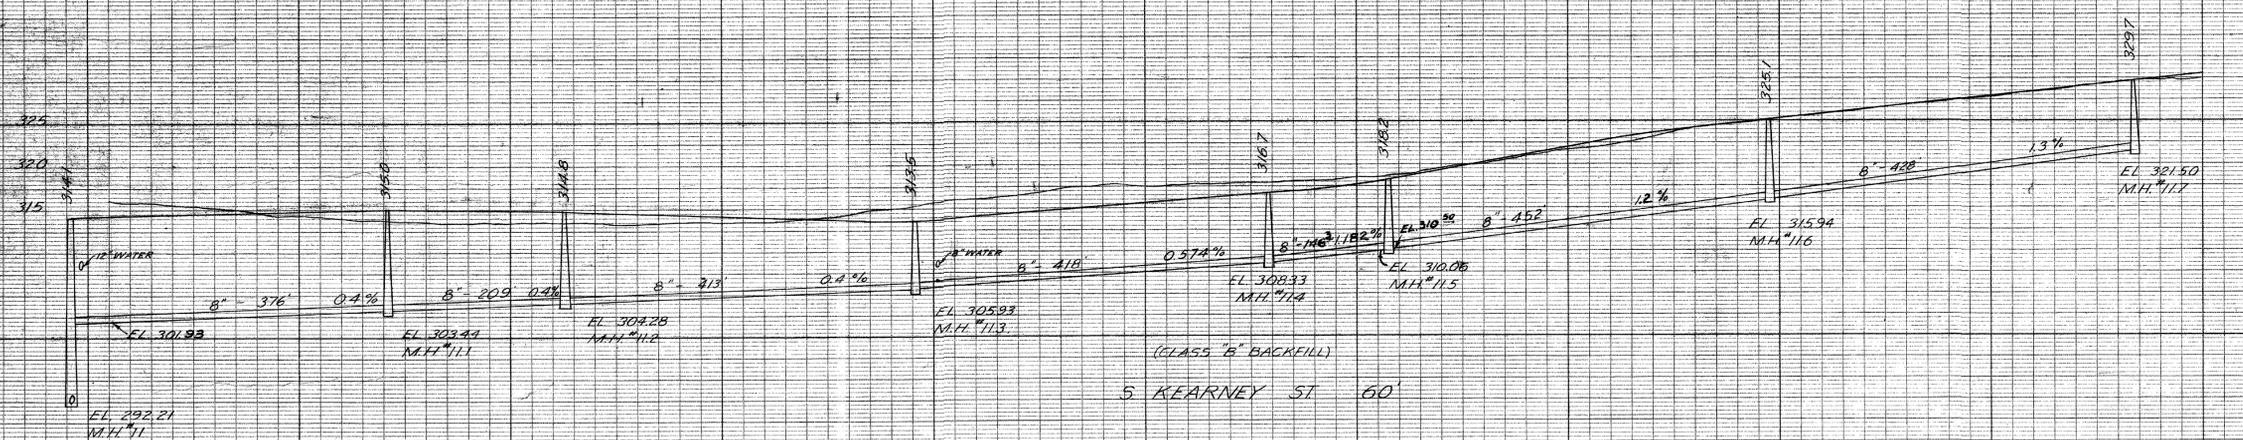
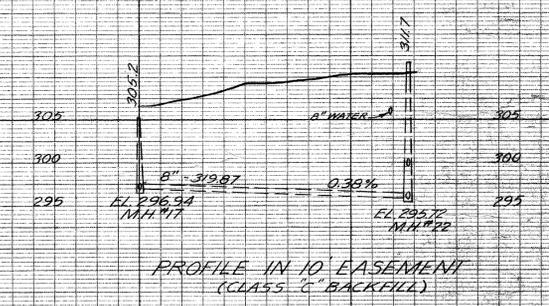
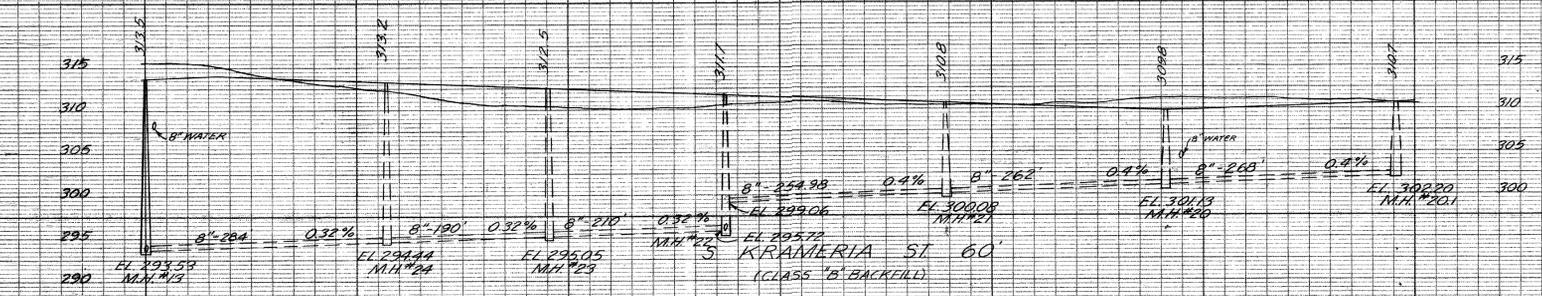
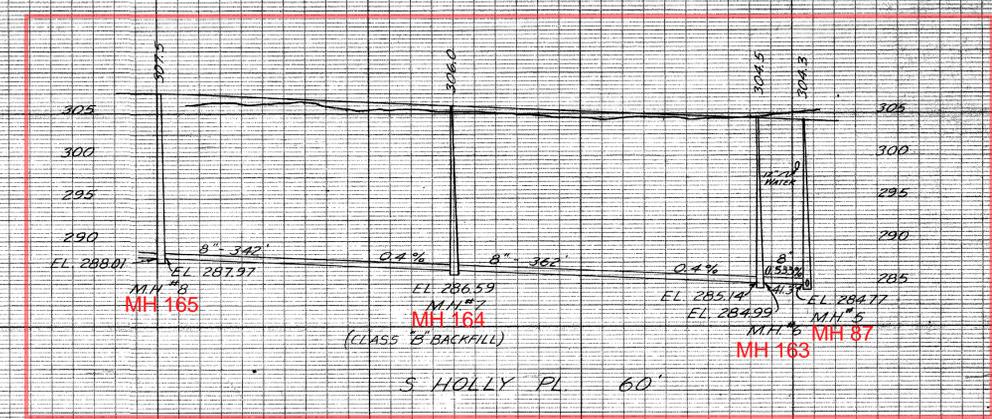



NOTE: ——— SOLID LINE, SEWER AS CONSTRUCTED
- - - - - BROKEN LINE, PROPOSED FUTURE CONSTRUCTION

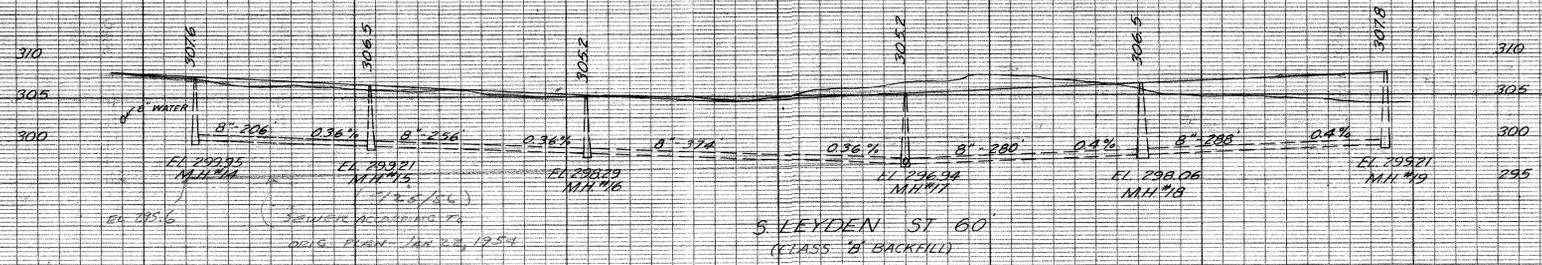

5315

AS CONSTRUCTED JAN. 30, 1956

NOTE:
— SOLID LINE, SEWER AS CONSTRUCTED.
--- BROKEN LINE, PROPOSED FUTURE CONSTRUCTION.

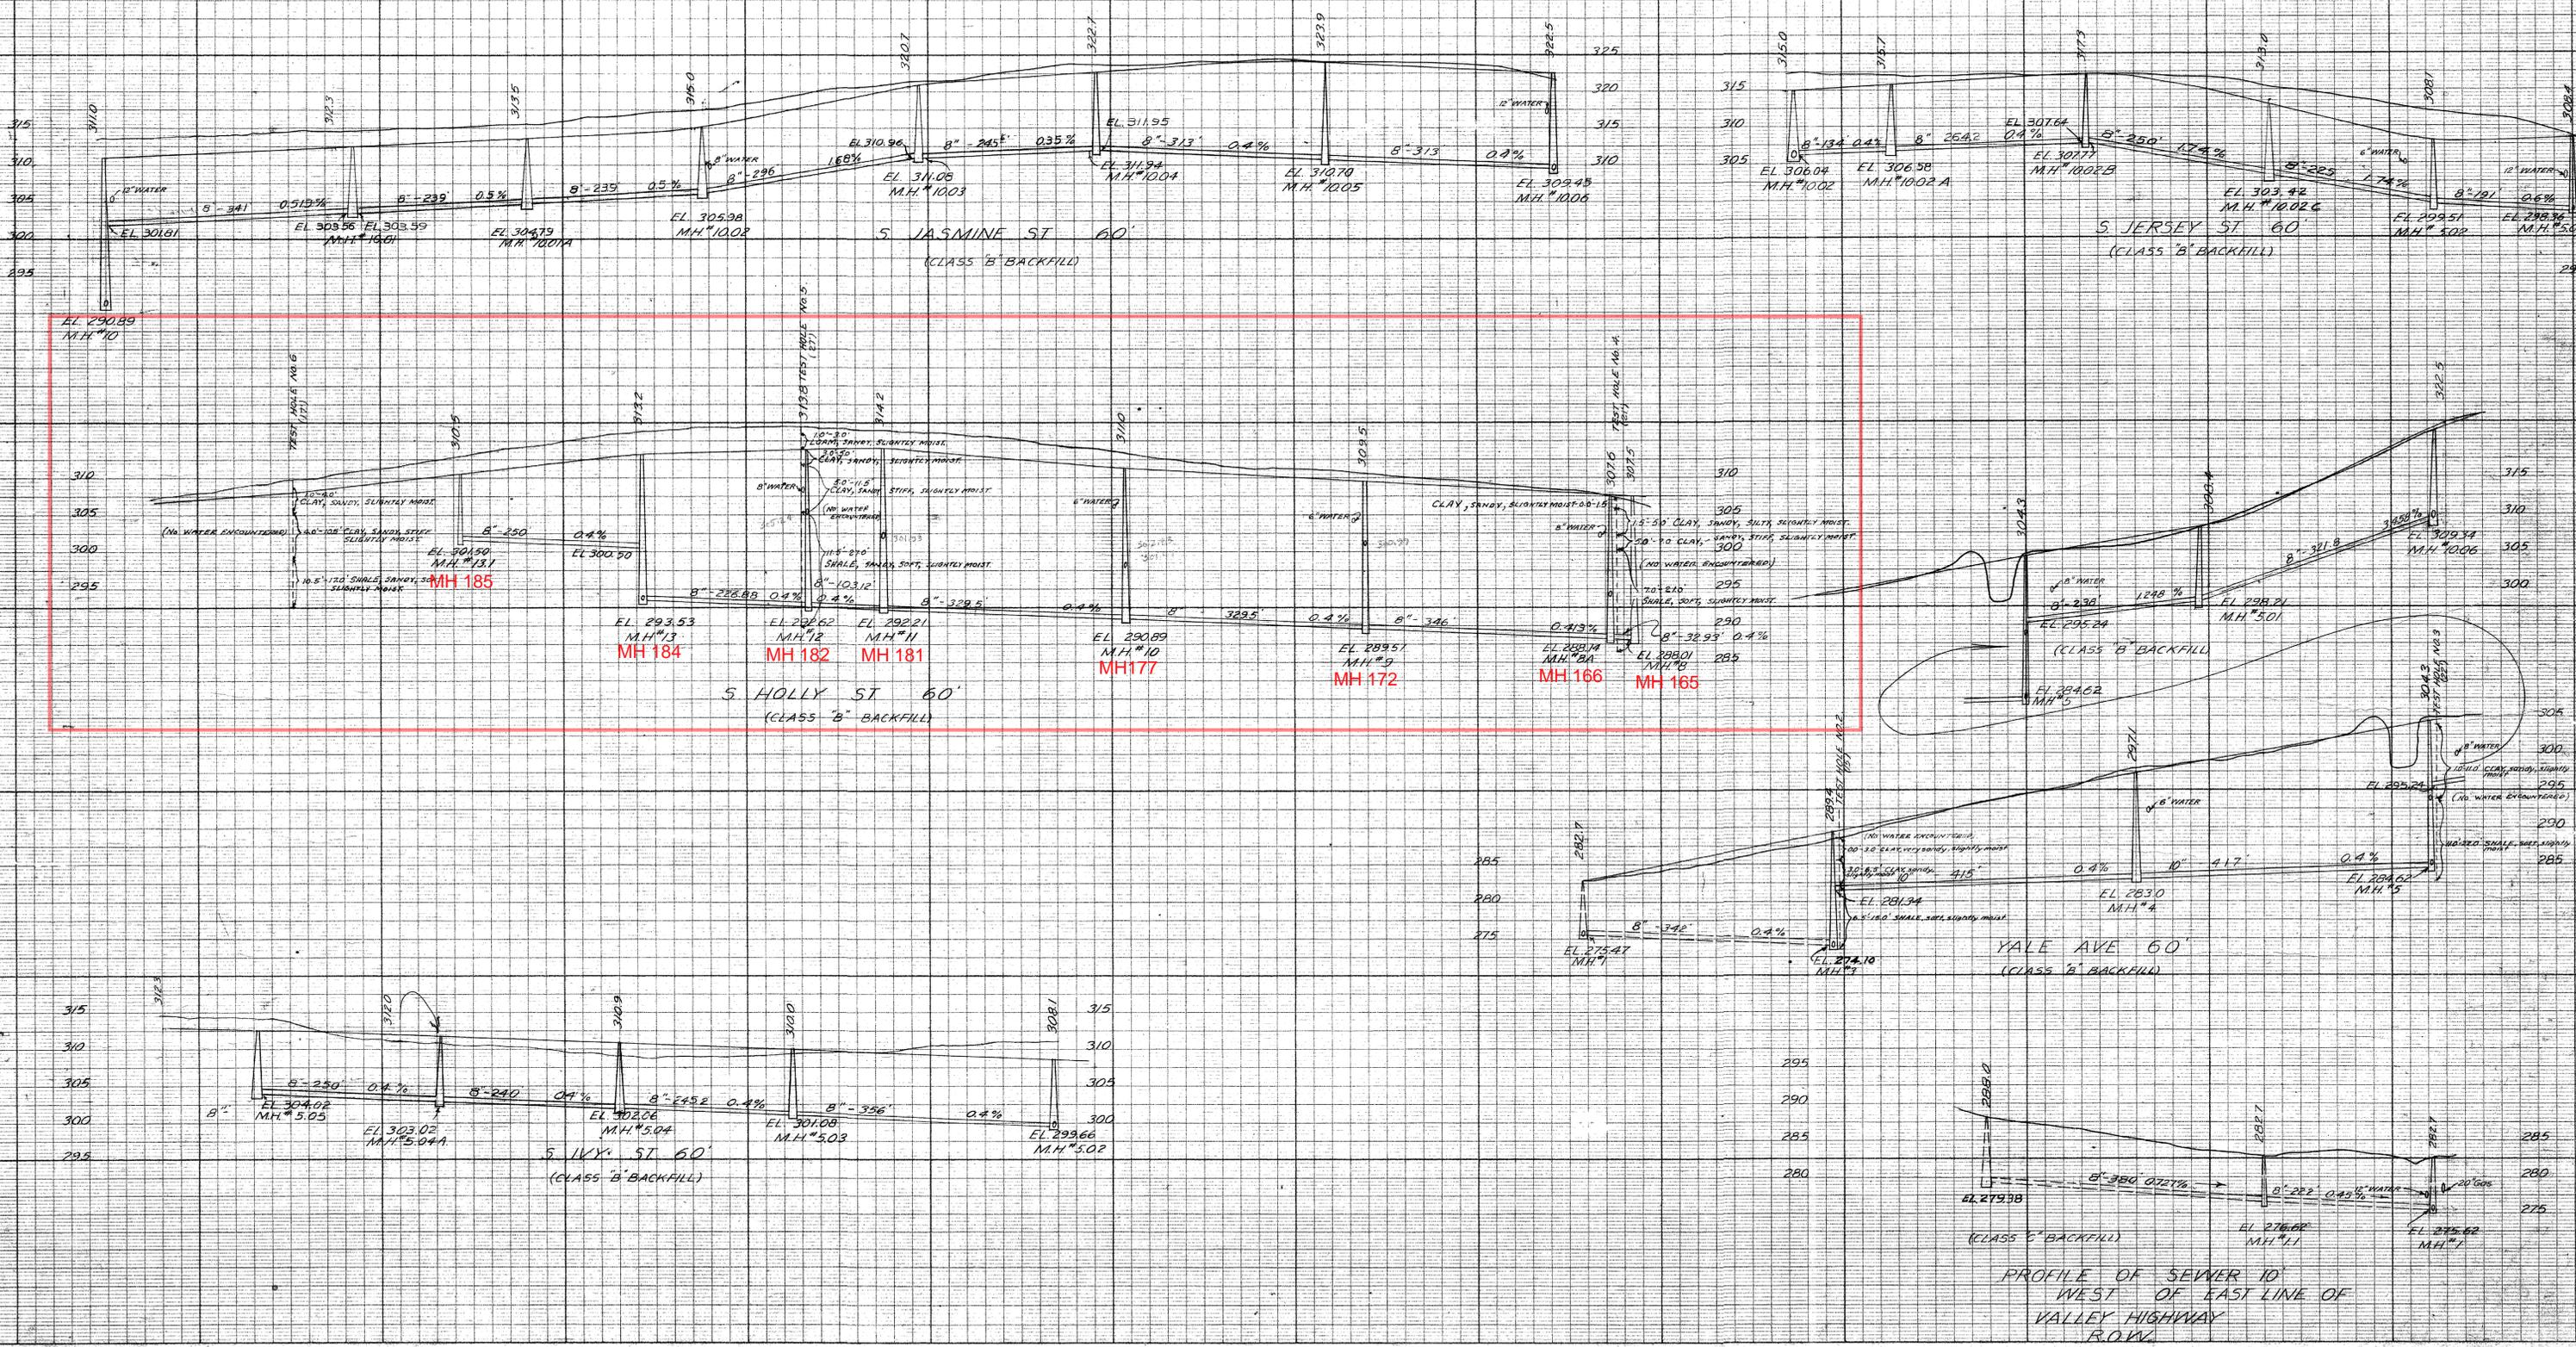

7774